

OWNERSHIP OF DOCUMENTS
This document and the ideas and designs incorporated herein as an instrument of professional services, is the property of Tobin & Associates, P.C. Tobin & Associates, P.C. are the author of this document and retain all common law, statutory and other reserved rights, including copyright. This document is not to be used, in whole or part, for any other project without the written authorization of Tobin & Associates, P.C. Copyright © 2018

PROJECT INFORMATION


AUTO TECH LIFT LOCATIONS
LARAMIE COUNTY COMMUNITY COLLEGE
1400 E. COLLEGE DR
CHEYENNE, WY 82007

OWNER
1400 E. COLLEGE DRIVE
CHEYENNE, WY 82001
CONTACT: BILL ZINC
P (307) 778-1256

DATE
PLOTTED ON 1/5/2018 1:08:20 PM
ISSUE DATE

NEW FLOOR PLAN

A1.01

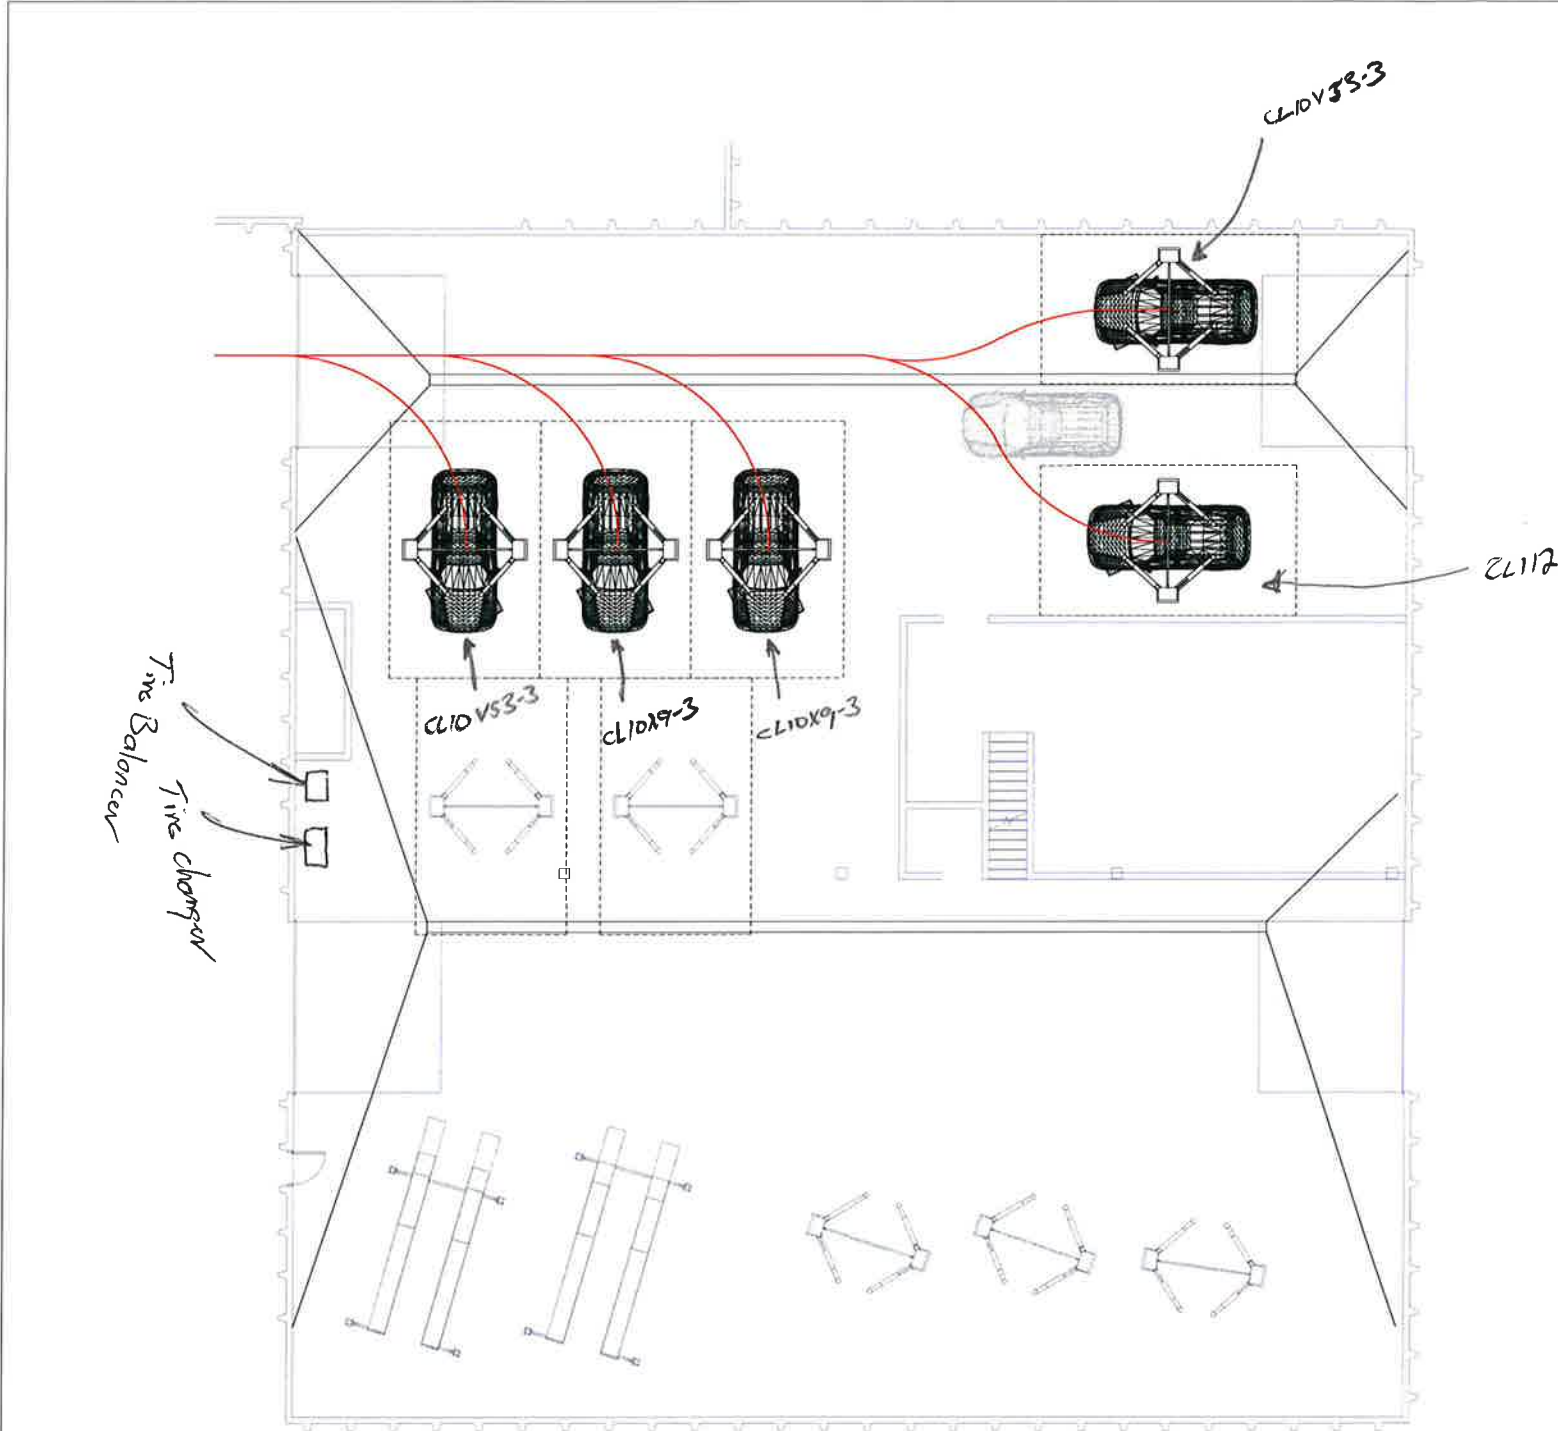

RED LINES IS TYPICAL TURN RADIUS FOR SUV
DASHED LINES ARE REQUIRED CLEARANCES

**NOT FOR
CONSTRUCTION**

1 First Floor- New Floor Plan
A1.01 1/8" = 1'-0"